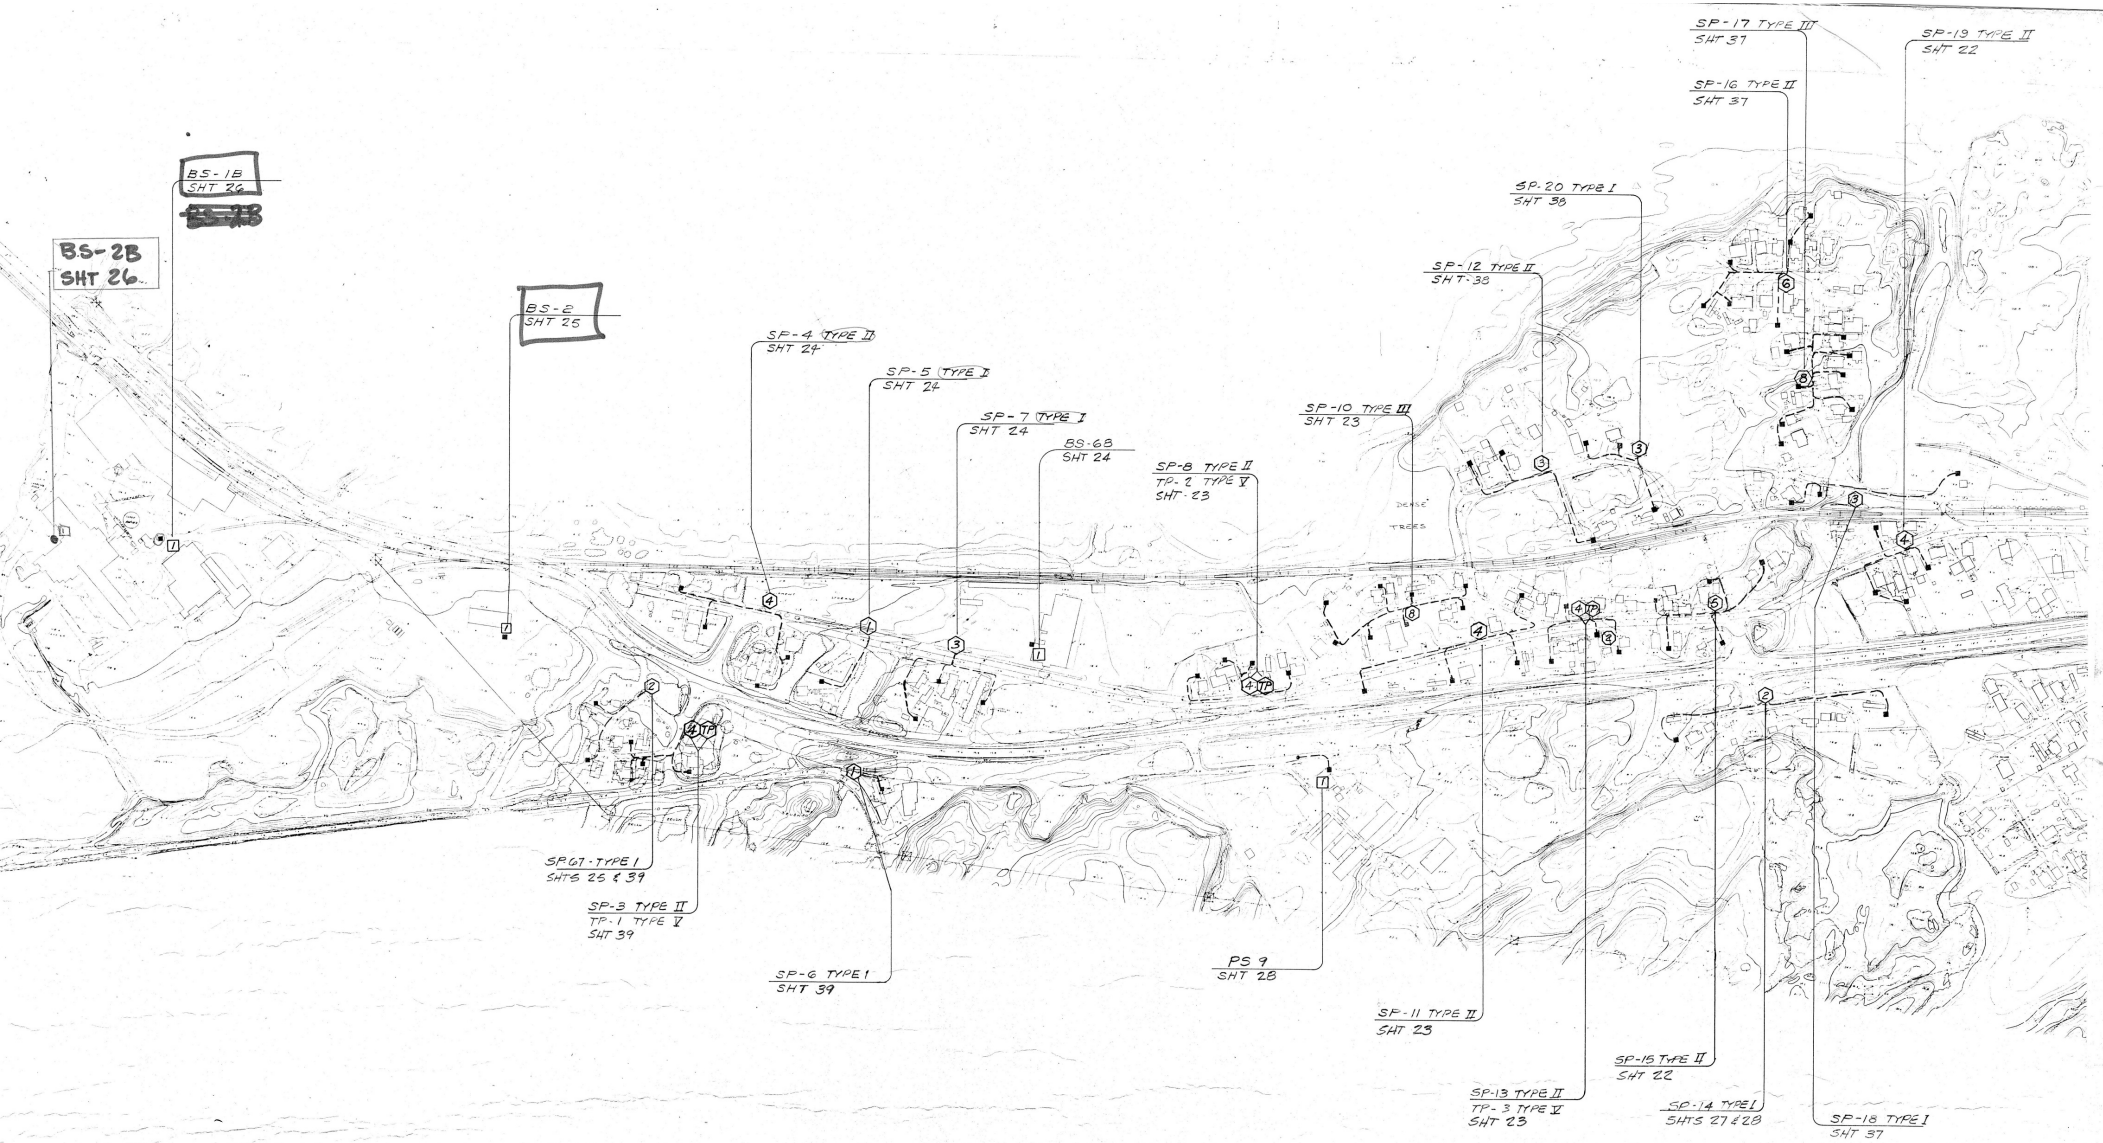

ABBREVIATIONS SHTS 16-20

A	AMP
BKR, CB	CIRCUIT BREAKER
CKT	CIRCUIT
ETM	ELAPSED TIME METER
FSD	DIFFERENTIAL FLOAT SWITCH
GND	GROUND
ISR	INTRINSICALLY SAFE RELAY
PB	PUSH BUTTON
PSD	DIFFERENTIAL PRESSURE SWITCH
PSL	LOW PRESSURE SWITCH
PSH	HIGH PRESSURE SWITCH
W	WIRE
ϕ	PHASE

ELECTRICAL LEGEND SHTS 16-47

- CONTROL PANEL (3/18) (4/18) (5/18)
- UTILITY POLE
- —-(N)PG&E—- NEW UNDERGROUND POWER SERVICE BY PG&E
- —-(N)PT&T—- NEW UNDERGROUND TELEPHONE SERVICE BY PT&T
- ---------(THIS SHEET ONLY) INDICATES WHICH CONTROL PANELS ARE CONNECTED TO EACH SERVICE PEDESTAL
- SEPTIC TANK LOCATION

- BS - BUILDING SERVICE - SEE (3/20)
- SP - SERVICE PEDESTAL - SEE (1/18) (2/18) - DENOTES NO. OF PUMPS CONNECTED
- TP - TELEMETRY PEDESTAL - SEE (4/20) (5/20)
- CSP - CUSTOMER SERVICE POLE - SEE (1/20)
- PS - POLE SERVICE - SEE (2/20)

RECORD DRAWING

THESE RECORD DRAWINGS HAVE BEEN PREPARED, IN PART, ON THE BASIS OF INFORMATION COMPILED AND FURNISHED BY THE PROJECT CONTRACTOR AND OTHERS. THE ENGINEER WILL NOT BE RESPONSIBLE FOR ANY ERRORS OR OMISSIONS WHICH HAVE BEEN INCORPORATED INTO THIS DOCUMENT AS A RESULT. FIELD VERIFICATION OF CRITICAL FACTS AND DATA SHOULD BE MADE IF THESE DOCUMENTS ARE TO BE USED AS A BASIS FOR FUTURE WORK.

NO.	DATE	REVISIONS	CHKD.	APPR.
2	4-23-80	AS BUILT	DT	DT
1	6/29/79	AS BUILT-GENERAL	DT	DT

SCALE 1"=200'
DSGN. RAK
DRWN. LM/HFM
CHKD. TJW
DATE JUNE '78

WINZLER & KELLY
CONSULTING ENGINEERS
APPROVED R. F. Kelly DATE 6/14/16
633 3RD ST. EUREKA, CALIFORNIA (707) 443 8326

REGISTERED PROFESSIONAL ENGINEER — TRAVIS J. WESTLUND — No. 7212 — ELECTRICAL — STATE OF CALIFORNIA

MANILA COMMUNITY SERVICES DISTRICT
S.T.E.P. SEWERAGE SYSTEM
ELECTRICAL INDEX SHEET

JOB NO. 77-015
SHEET 16/66